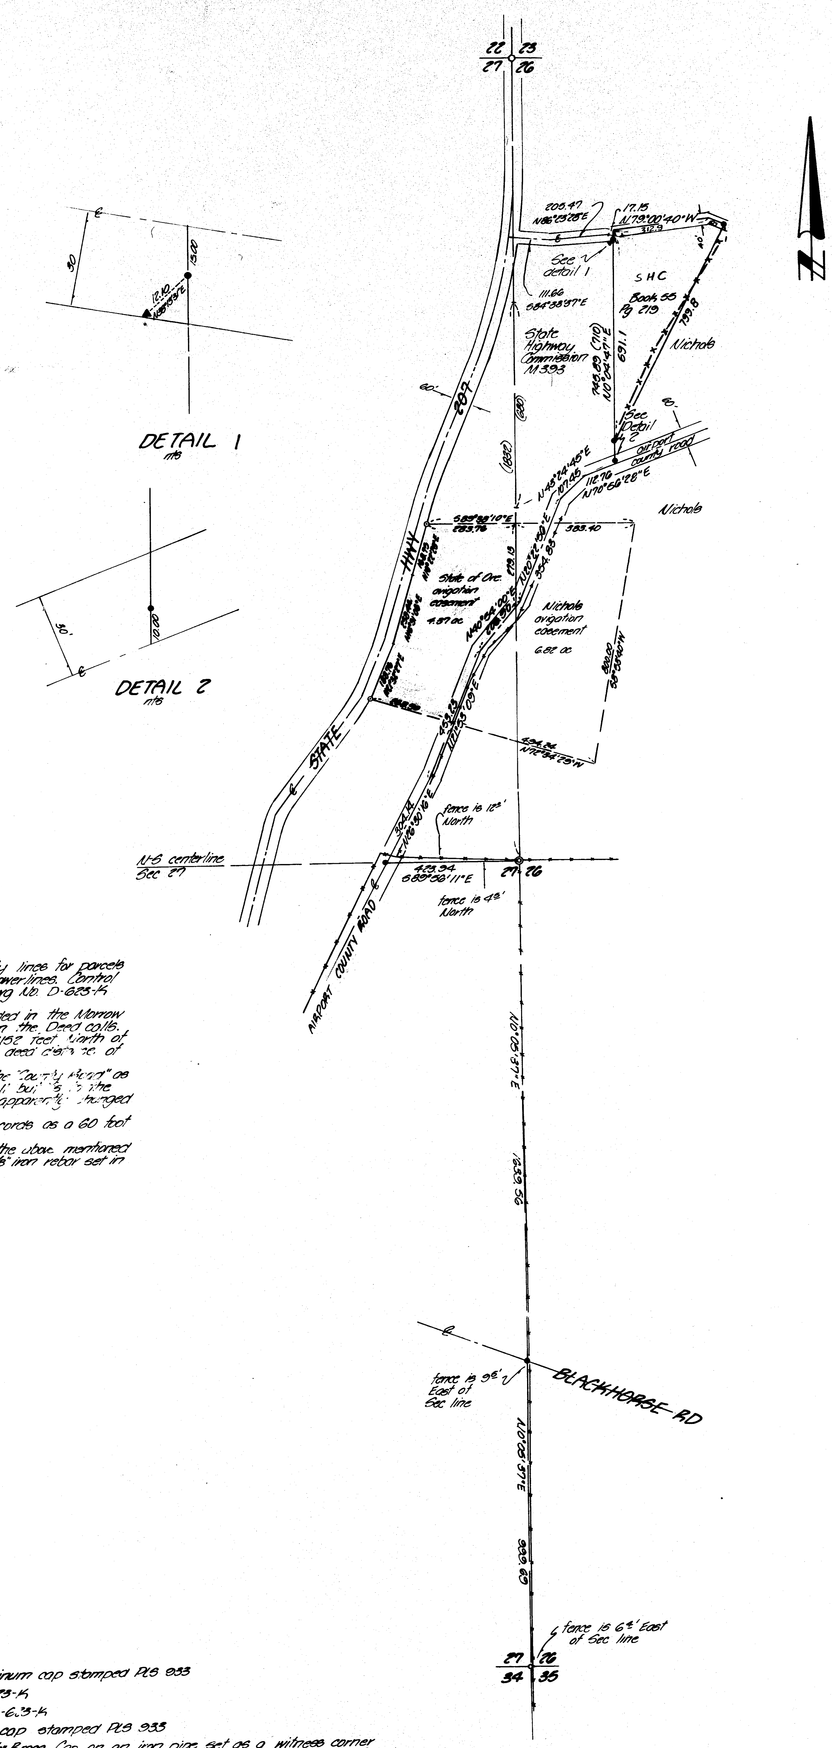


## NARRATIVE

The purpose of this survey was to establish various property lines for parcels along which Columbia Basin Electric Cooperative wish to run power lines. Control for this survey was based upon Morrow County Surveyors Drwg. No. D-623-K for the Morrow County Airport.

The parcel belonging to the State Highway Commission, recorded in the Morrow County Deed Records on Microfilm No. 393, was laid out from the Deed calls. The South line of the State property was established as being 1152 feet North of the quarter corner and thence at a 64° to the section line "the deed calls" of 395 feet.

The East line was run North parallel to the section line to the "County Road" as called for in the deed. This distance is longer than the deed call but is the apparent county road. The alignment of the county road has apparently changed because of erosion by the Highway Commission.

The Airport County Road is well defined and shows on the records as a 60 foot right-of-way.

The Southeast quarter of Section 27 was broken down from the above mentioned survey and a tie to the Southwest section corner which is a 5/8" iron rebar set in 1979 by the County Surveyor.

Bearings are based upon County Surveyor Drwg. No. D-623-K.

- • denotes set 5/8 x 30" iron pin with aluminum cap stamped PLS 933
- • denotes found 5/8" iron pin, Co. No. D-623-K
- ◉ denotes found 2½" Brass Cap, Co. No. D-623-K
- ○ denotes found 1/2" spike with witness cap stamped PLS 933
- ∘ denotes found 5/8" iron rebar with a 2½" Brass Cap on an iron pipe set as a witness corner lying 10' North on the Section Line. Set in County Surveyor No. D-256-K
- ▾ denotes found 5/8" iron rebar, OSHD
- ( ) denotes deed call

| | | | | |
|---|---|---|---|---|
| KRUMBEIN ENGINEERING LTD. ENGINEERS – SURVEYORS – PLANNERS 381 S.E. Second Pendleton, Oregon | Scale 1"=100' | Drn. By MLD | Dwg. No. 86-11 D | Revision 1 |
| | Date 7-28-86 | Ckd. By CHK | Job No. 86-81 | Revision 2 |
| Survey for COLUMBIA BASIN ELECTRIC | REGISTERED PROFESSIONAL LAND SURVEYOR OREGON DAVID M. KRUMBEIN | RECEIVED BY Morrow County Surveyor Date 12/4/86 Rec'd By DMD No. D-842-K | | |
| East Sec. line, Sec. 27, T1S, R28E, W.M. | | | | |

D-842-K-[redacted]